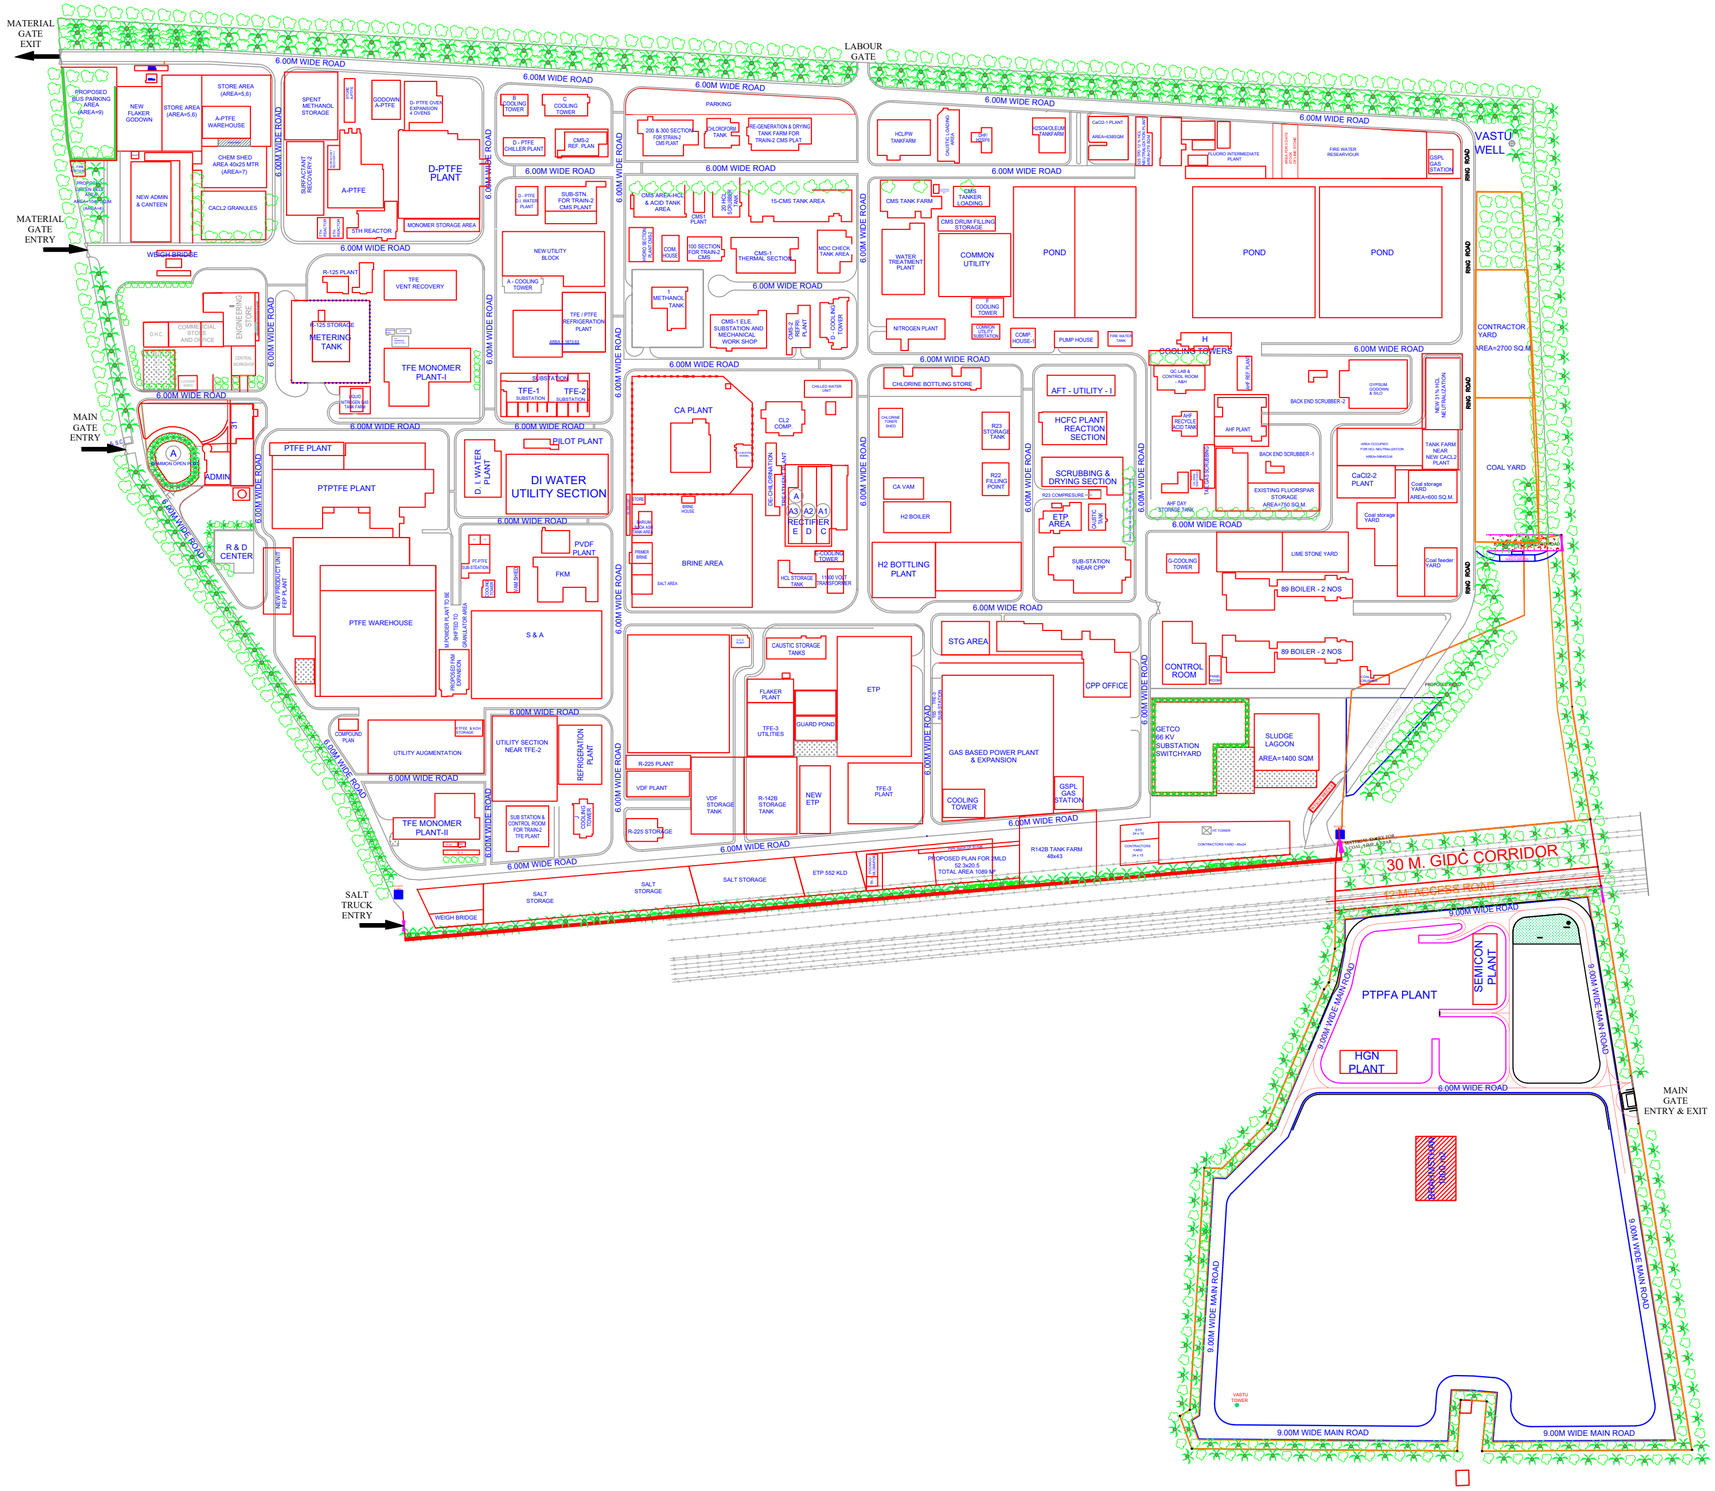


Notes:-

(1) ALL DIMENSION ARE IN MM, UNLESS SPECIFY.
(2) DRAWING CHECK BEFORE EXECUTION OR ORDER.
(3) PLEASE REVIEW THE DRAWING AND APPROVE BEFORE EXECUTION.
(4) DRAWING DRAWN AS PER GIVEN INPUTS.

Revision	Description	Date	Drawn	Chk'd.	Appd.
3	-	-	-	-	-
2	-	-	-	-	-
1	AS BUILT	21.02.2025	VMM	PP	SB

REVISION STATUS

GUJARAT FLUOROCHEMICALS LIMITED

DAHEJ COMPLEX, BHARUCH

PLANT: GFL A | AREA CODE: GFL A | EQPT :00

TITLE : BLOCK DIAGRAM OF GFL A

BY	NAME	SIGN.	DATE	PROJ:	SCALE: NTS
APPD	AP		11.02.25		
CHKD	AP		11.02.25	DRG.NO	REV.
DRAWN	VMM		11.02.25	GFL-COM-CIVL-LYOD-D1376	00
SHEET:	1 OF 1				

CAD NO.: